



Blue Flag Iris
Iris Versicolor



Jacob Cline Beebalm
Monarda Didyma "Jacob Cline"



Shenandoah Switchgrass
Panicum Virgatum "Shenandoah"



Goldstrum Black Eyed Susan
Rudbeckia Fulgida "Goldstrum"



Stella de Oro Daylily
Hemercallis "Stella de Oro"



Coneflower
Echinacea purpurea



NATIVE PLANTINGS LIST

TO SUPPORT POLLINATORS

RAIN GARDEN

PURPOSE/ BENEFIT

Reduce pollutants from stormwater runoff prior to discharging filtered stormwater to Cranberry River.

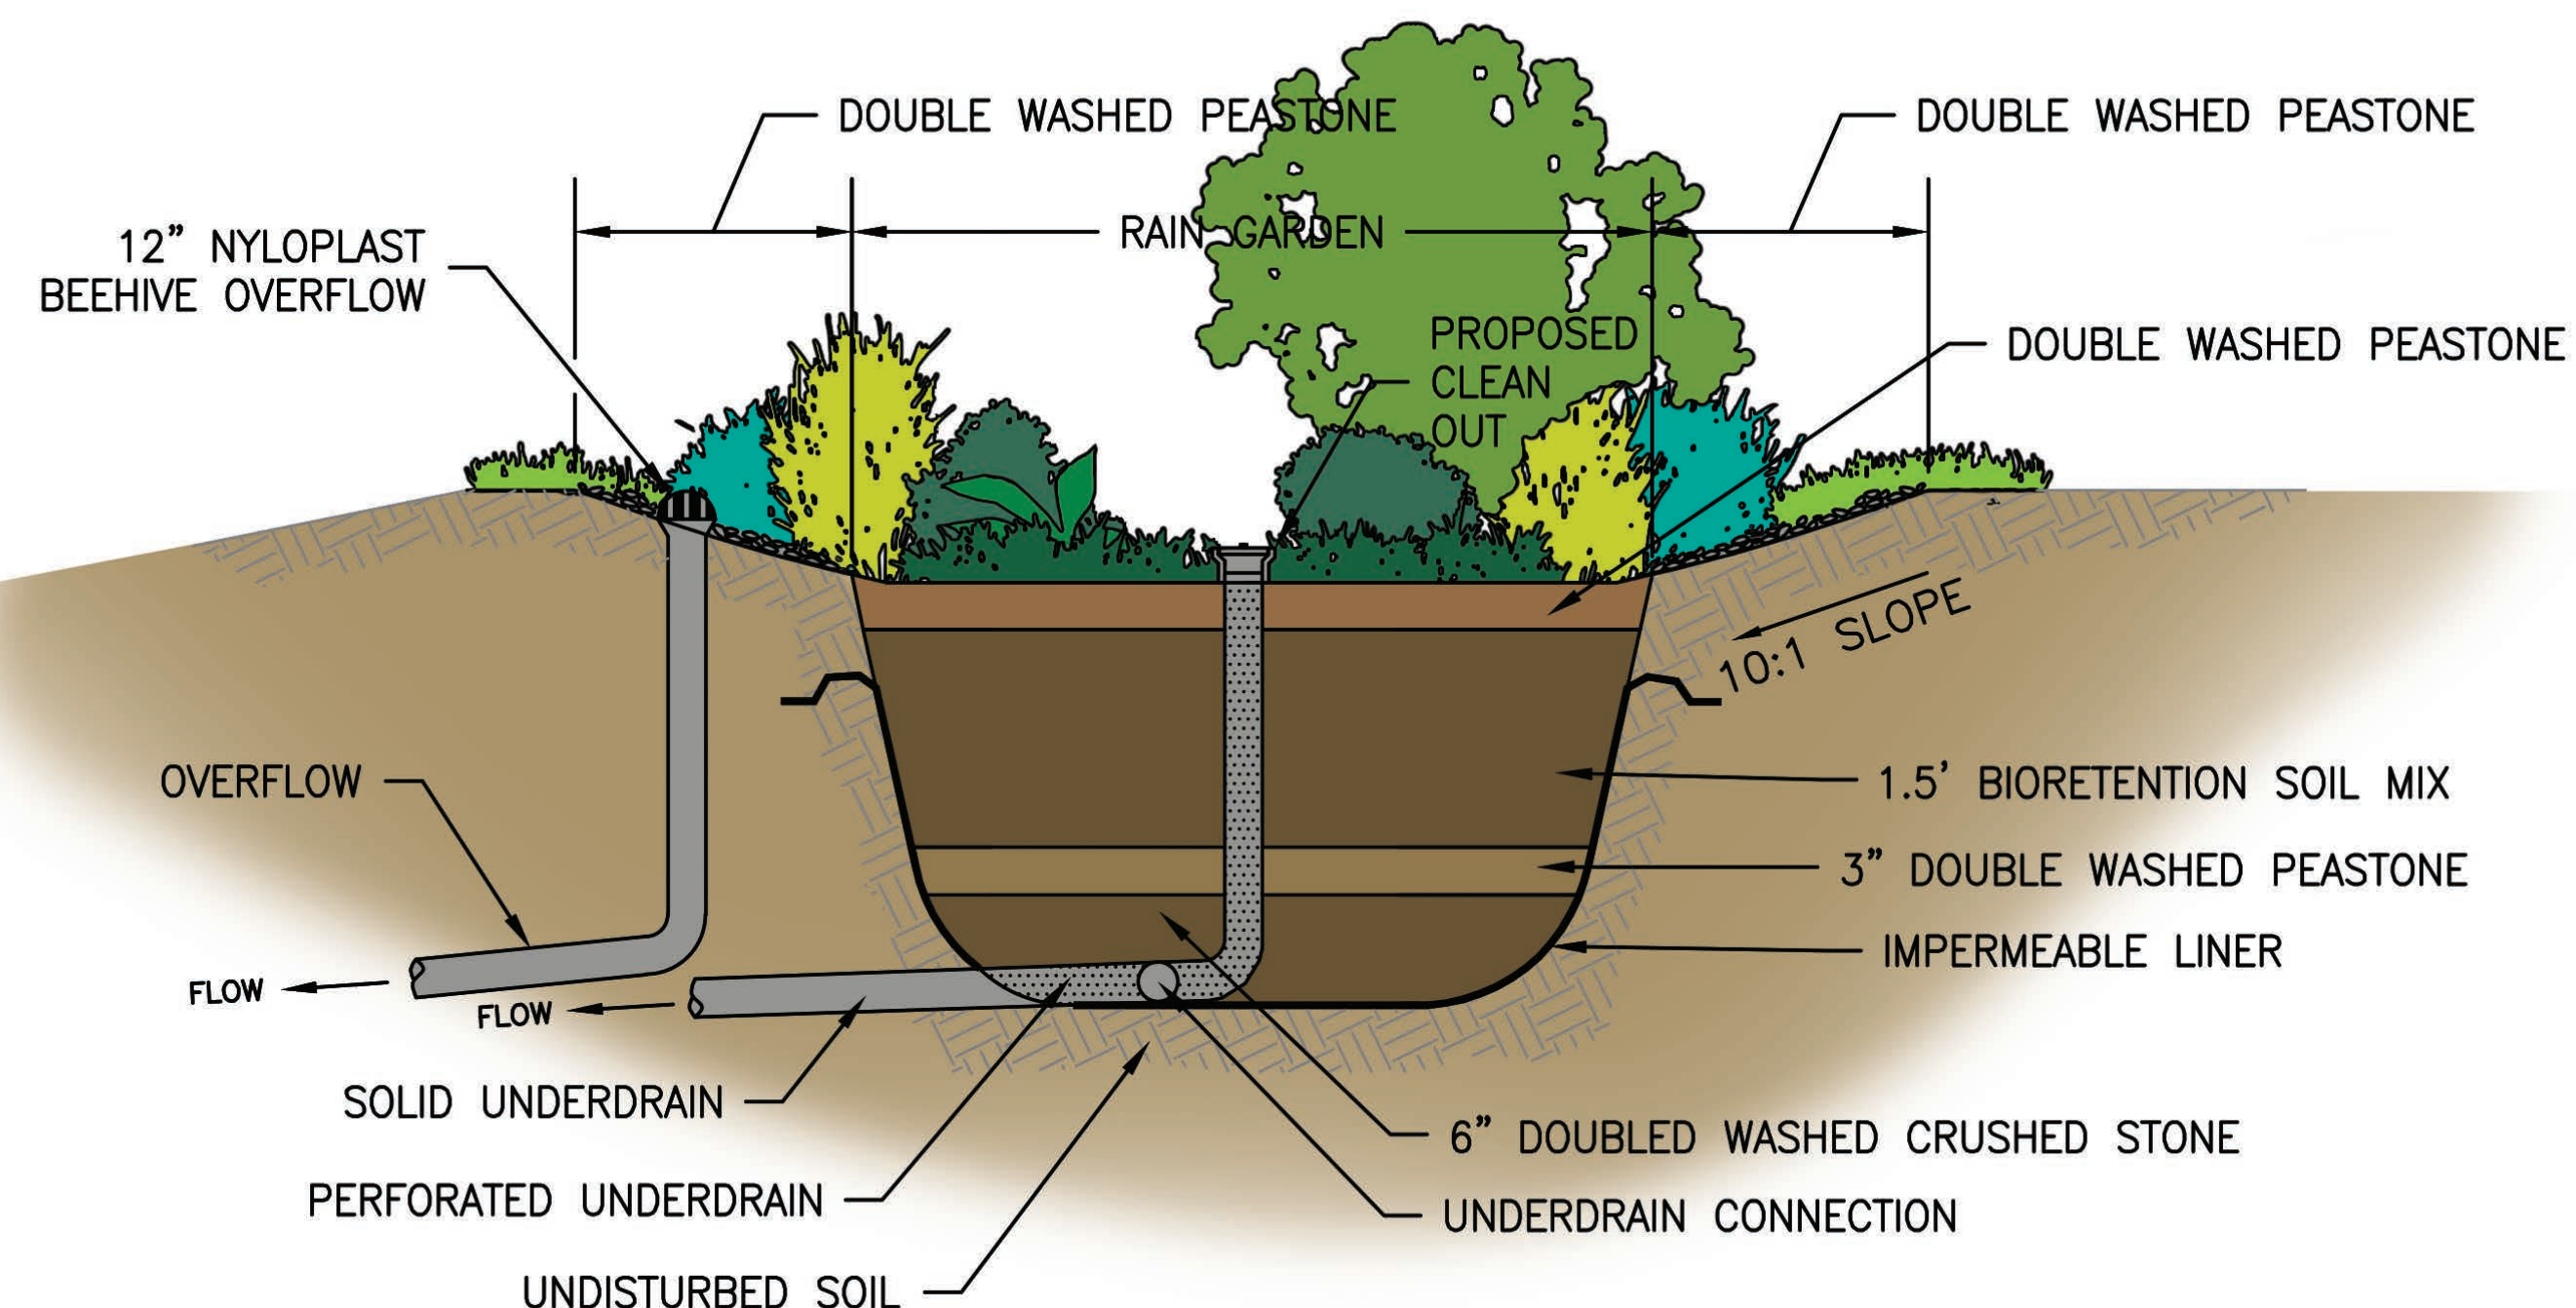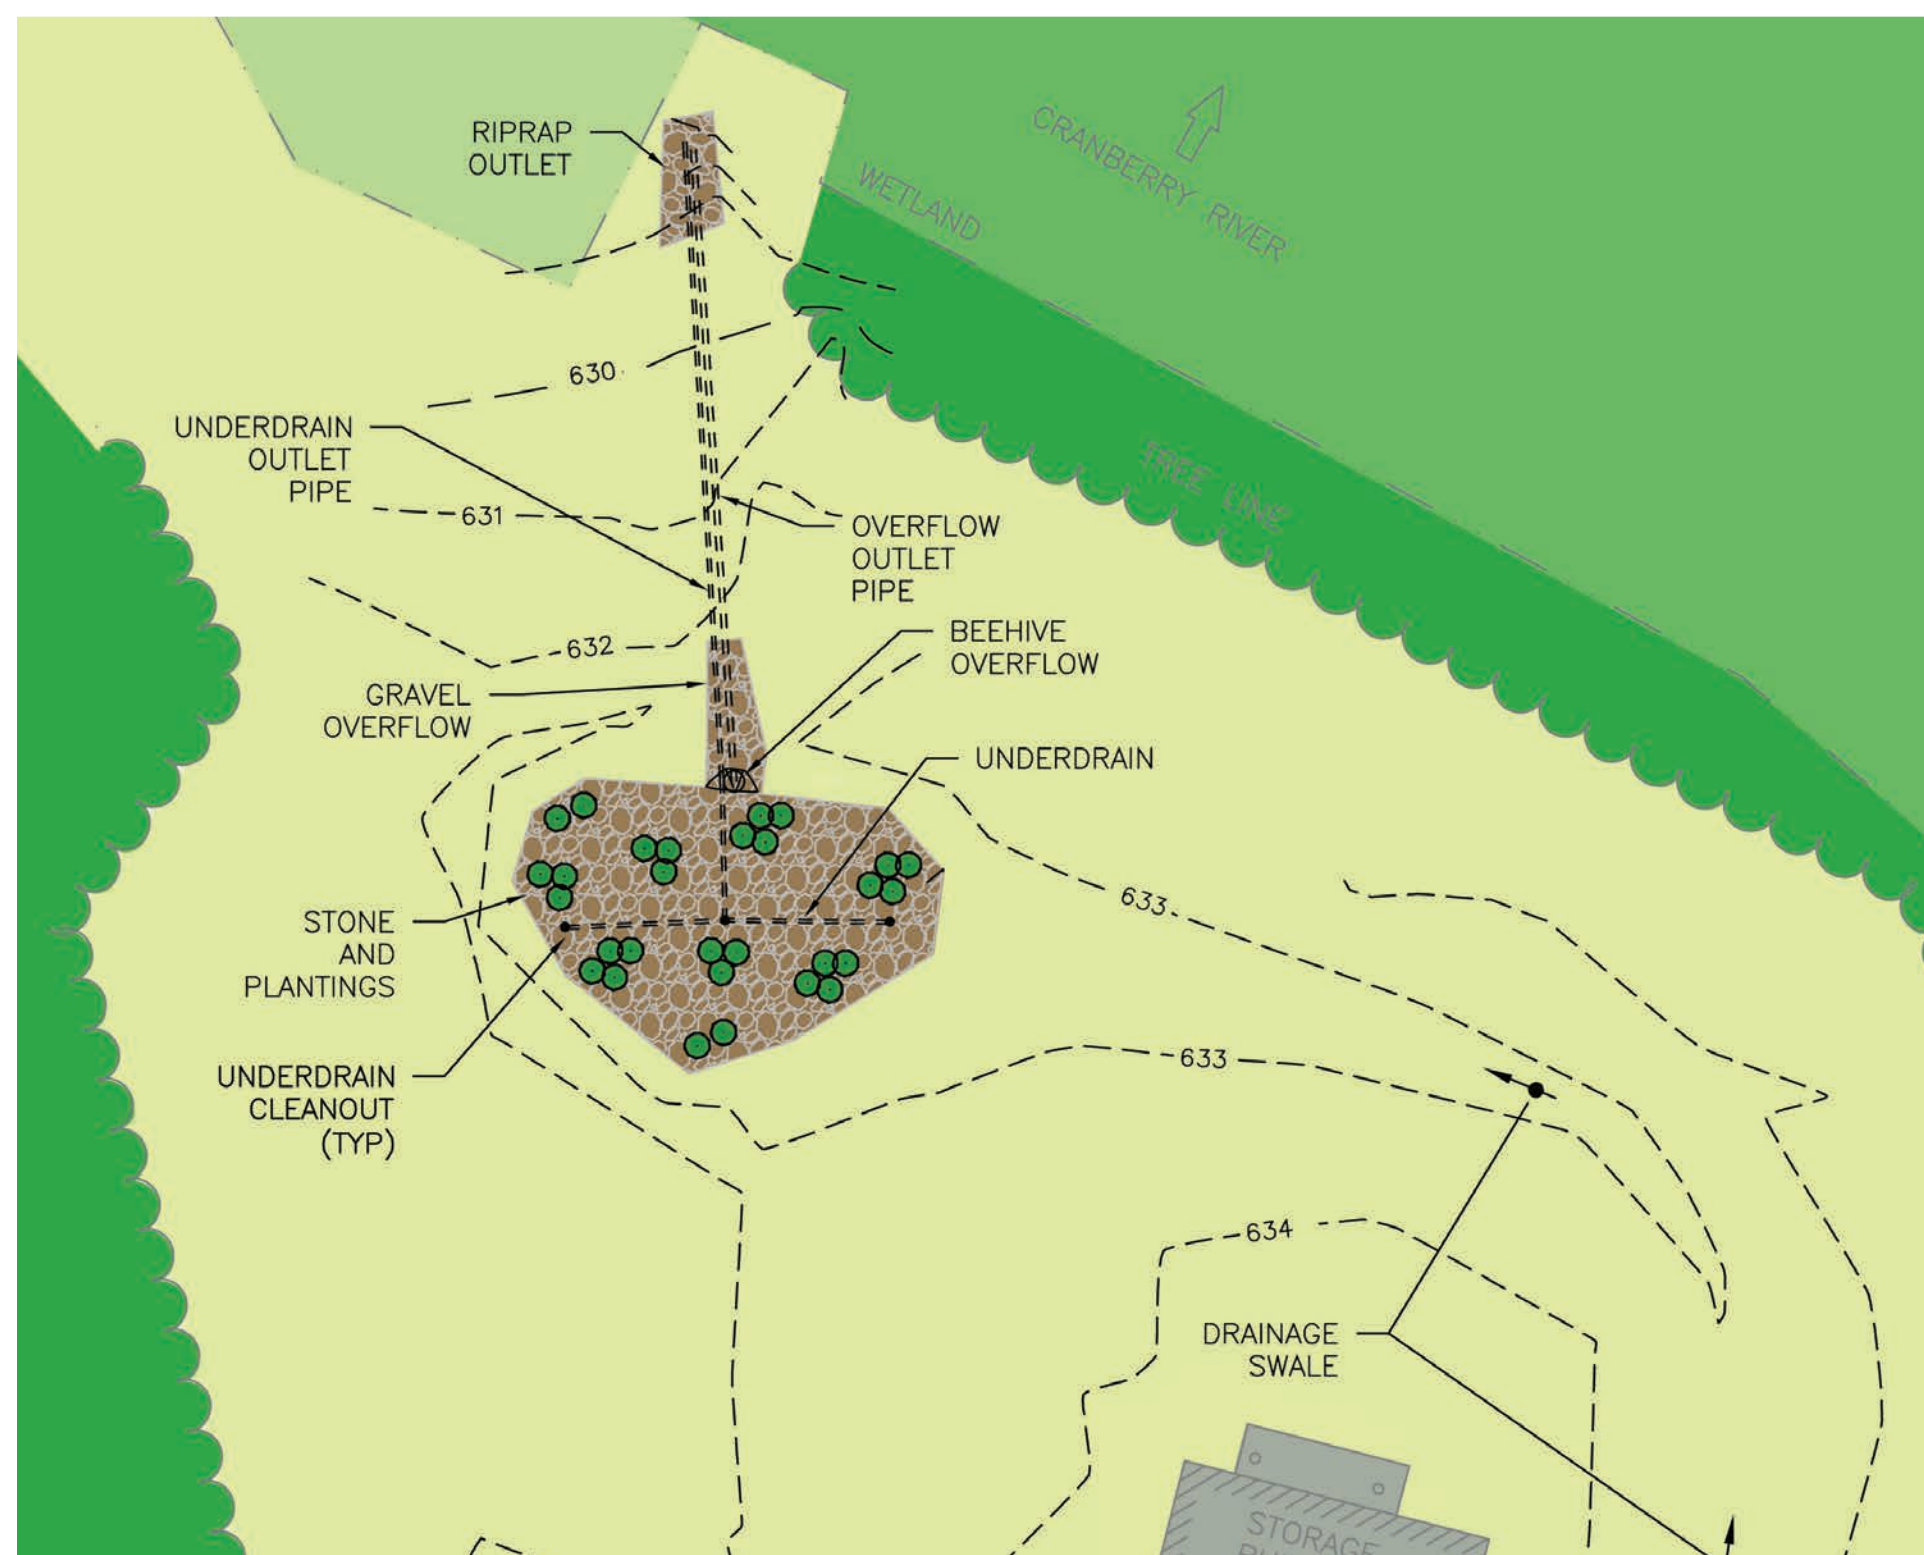

WATER QUALITY ACTIONS


The soils and plants in this rain garden remove stormwater pollutants through (1) filtering larger sediment particles, (2) uptake of phosphorus and nitrogen, and (3) microbial activity within the roots and soil.

DESIGN


This rain garden has an impermeable liner due to high groundwater at the site. Runoff reaching the garden travels through the plant roots and soil prior to reaching the underdrain which then discharges filtered stormwater to Cranberry River. The rain garden was sized to filter the first 0.5 inch of rain from the tributary area. The native plants were selected based on the site conditions such as light exposure and tolerance to wet/dry environment.



S:\1951\ACTIVE\19510340\DESIGN\DRAWINGS\CAD\CRANBERRY WELL RAIN GARDEN DESIGN.DWG
4/15/2017 2:52 PM

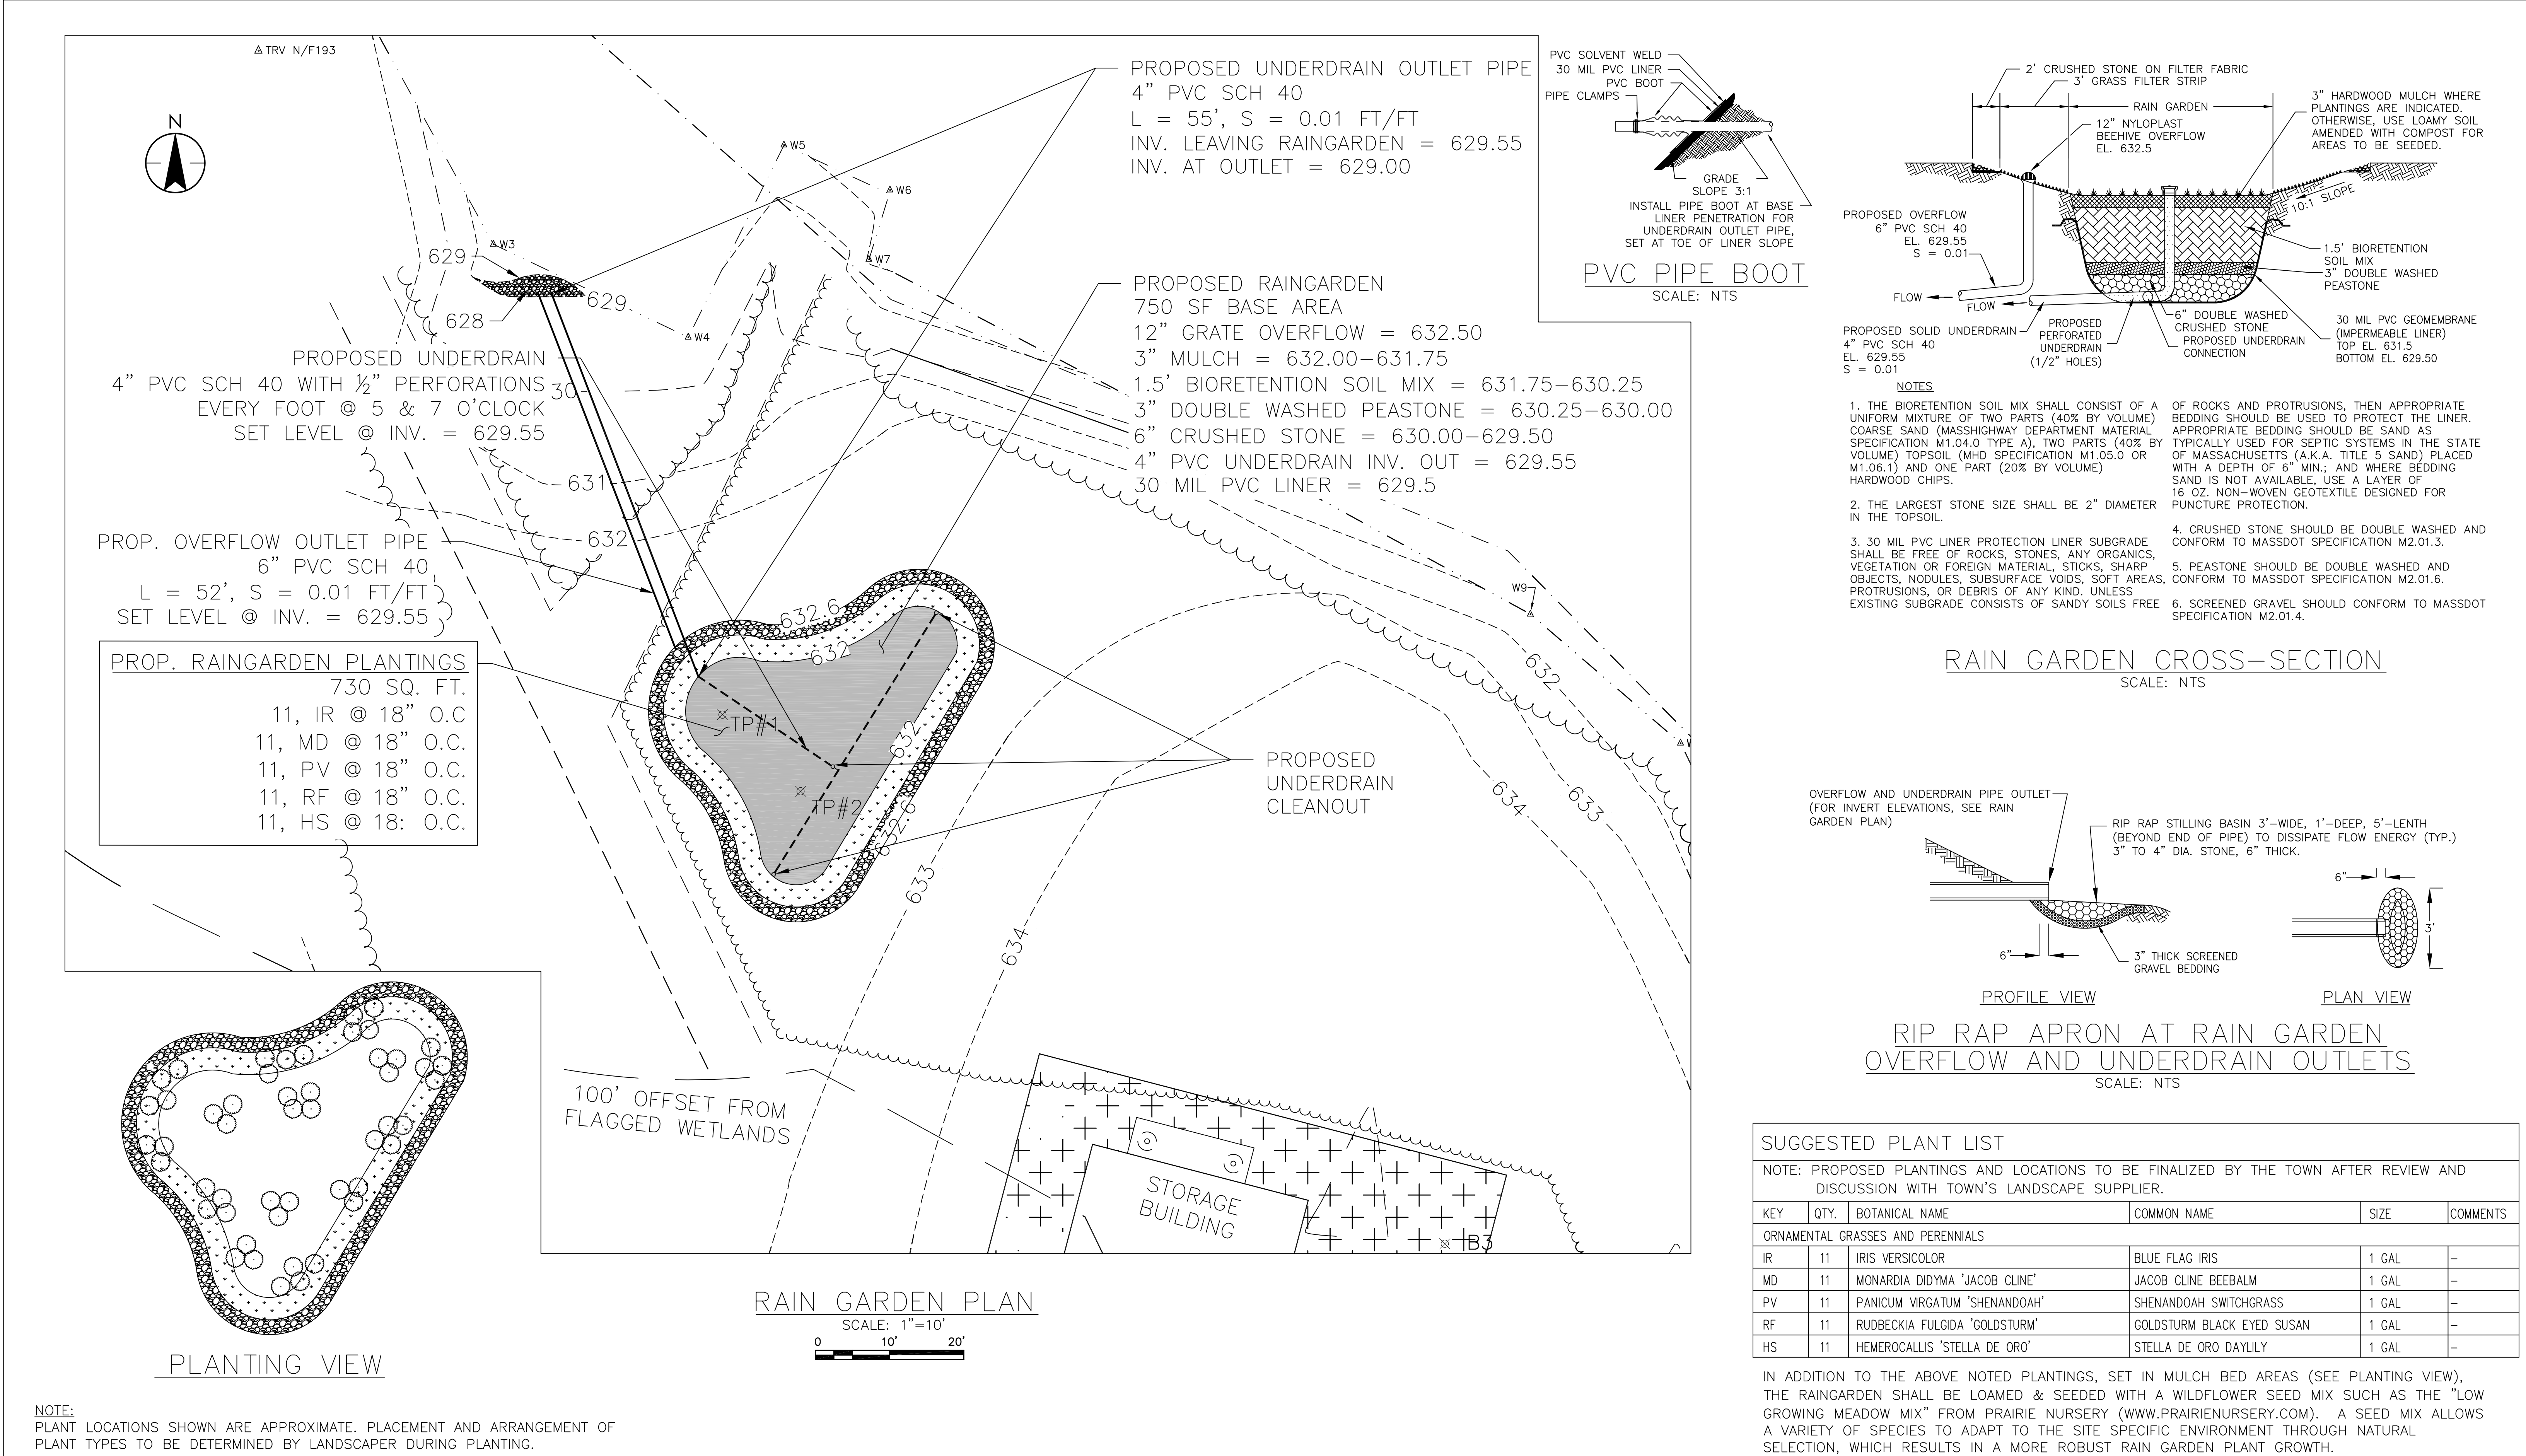

<div>_____</div> <div>_____</div> <div>_____</</div>			
--	--	--	--

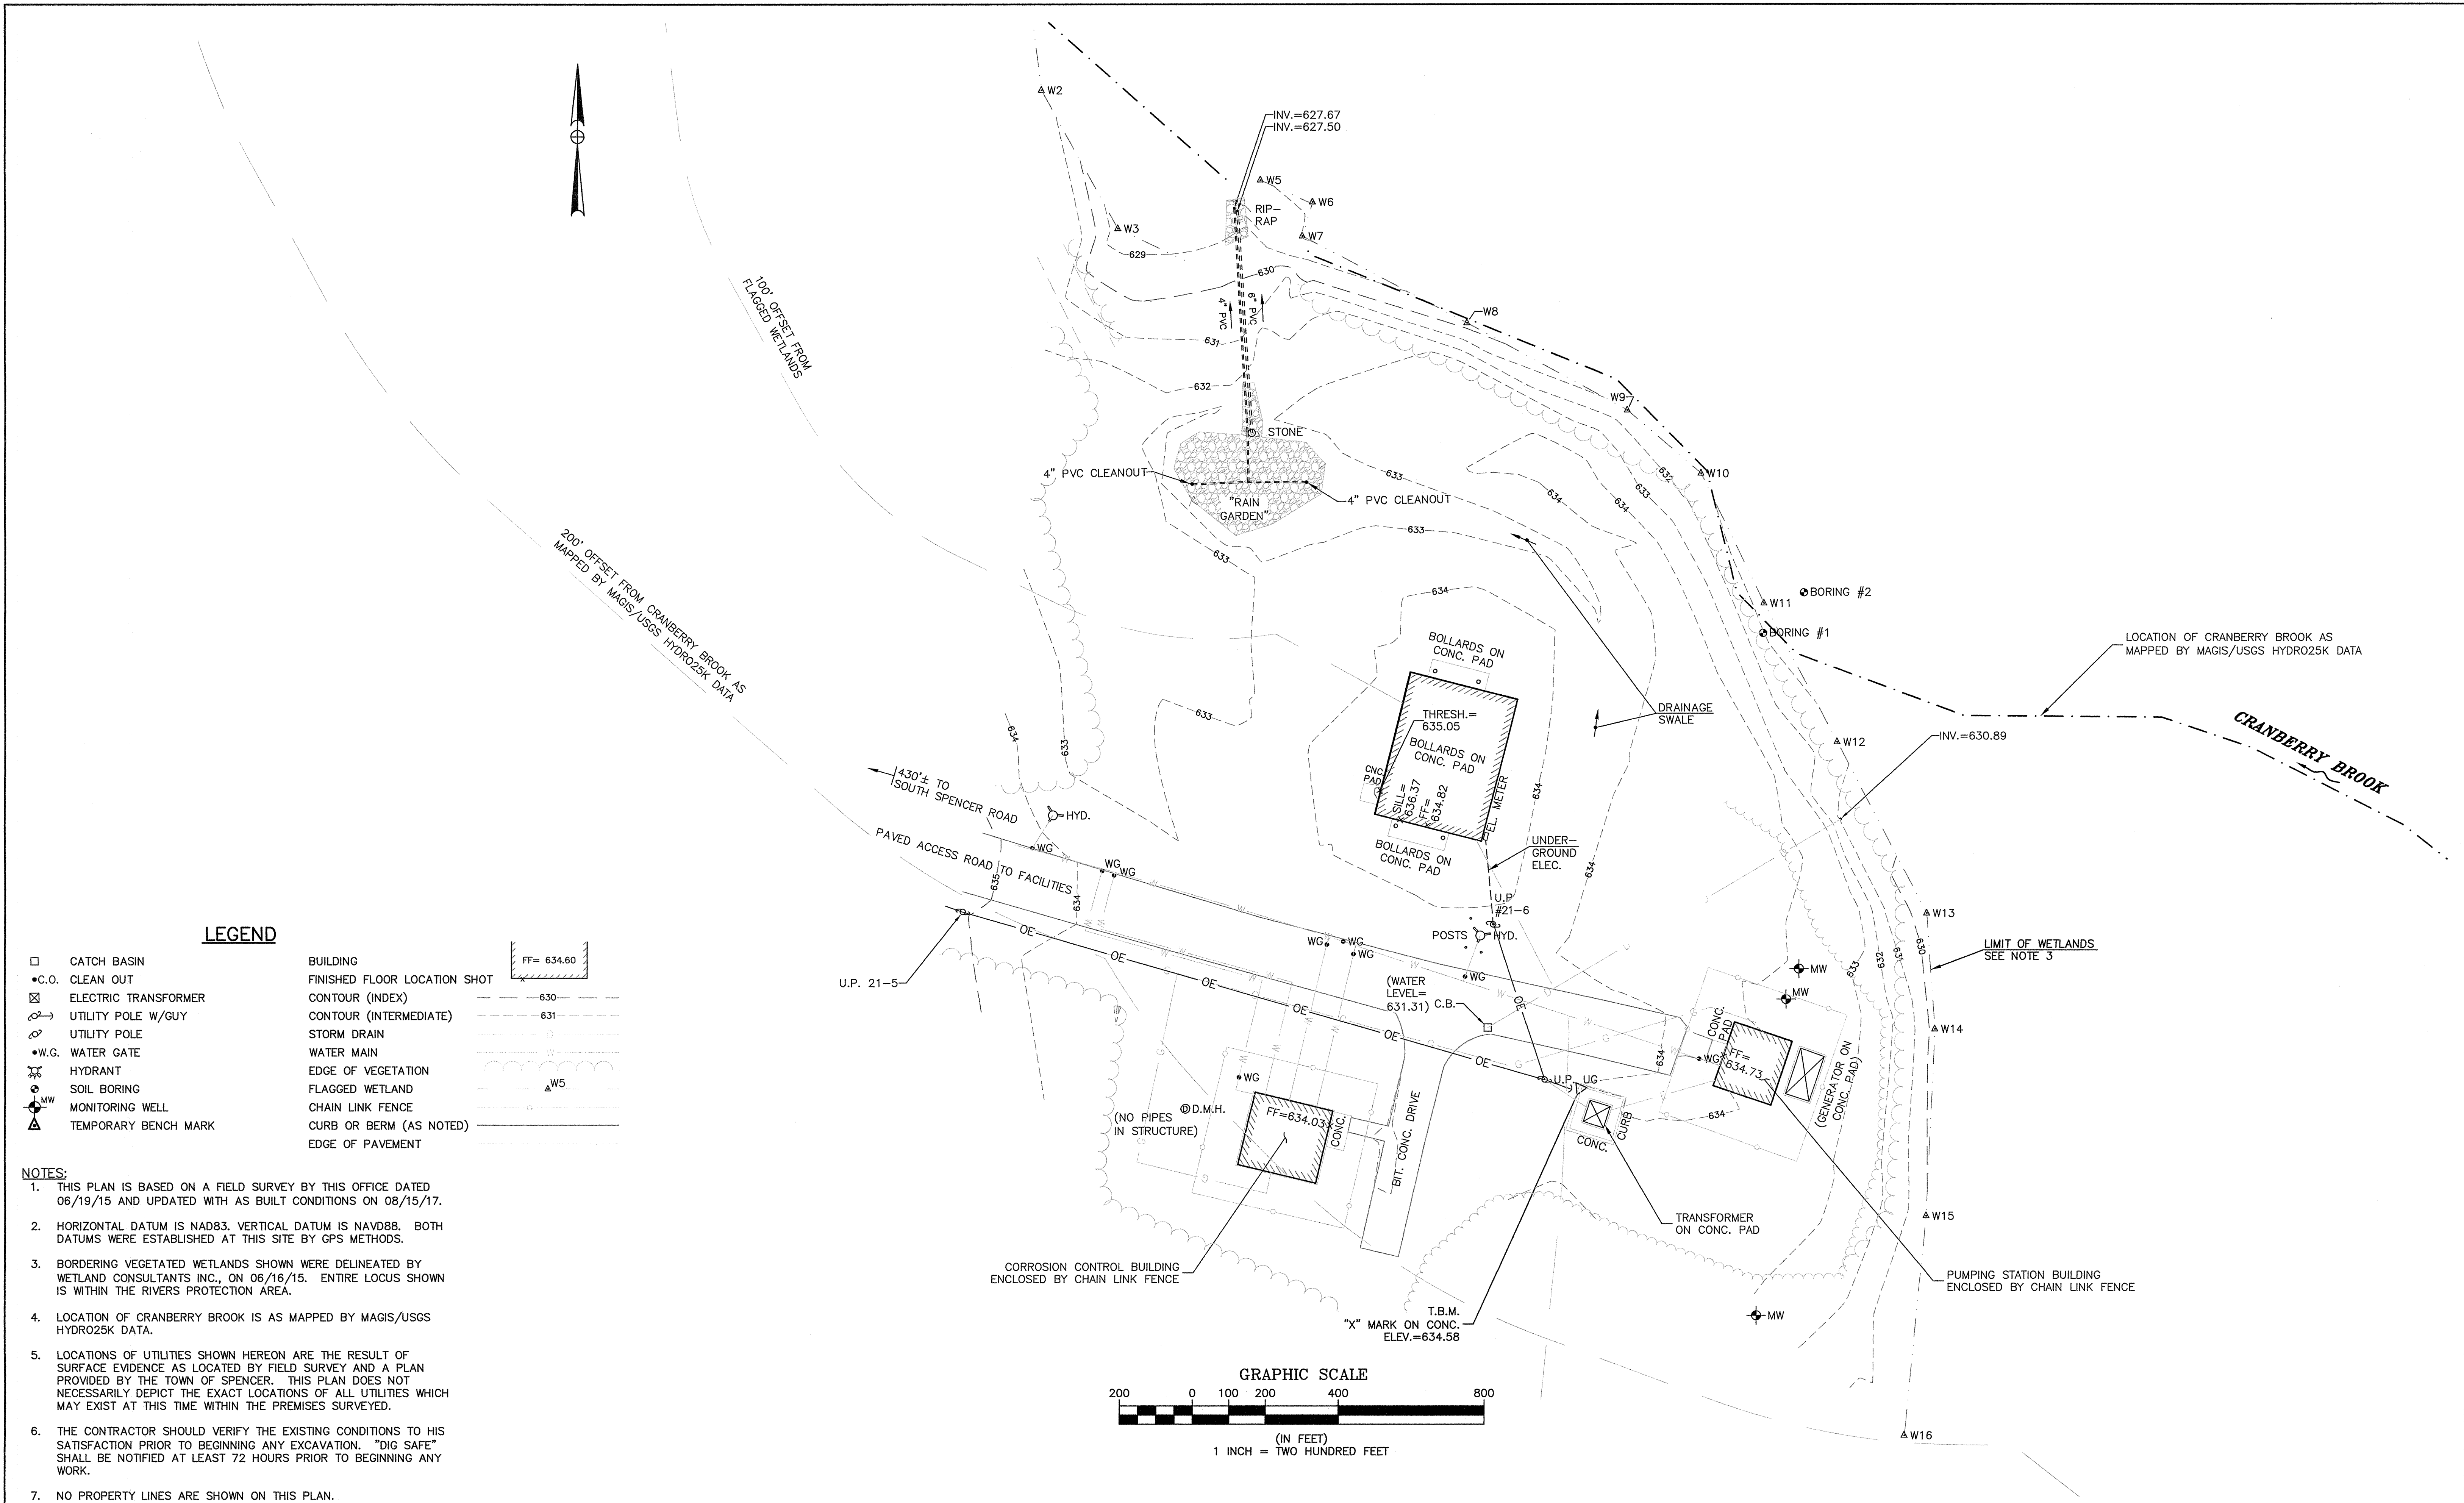

LEGEND


CATCH BASIN	BUILDING
C.O. CLEAN OUT	FINISHED FLOOR LOCATION SHOT
ELECTRIC TRANSFORMER	CONTOUR (INDEX)
UTILITY POLE W/GUY	CONTOUR (INTERMEDIATE)
UTILITY POLE	STORM DRAIN
W.G. WATER GATE	WATER MAIN
HYDRANT	EDGE OF VEGETATION
SOIL BORING	FLAGGED WETLAND
MONITORING WELL	CHAIN LINK FENCE
TEMPORARY BENCH MARK	CURB OR BERM (AS NOTED)
	EDGE OF PAVEMENT

- NOTES:**
1. THIS PLAN IS BASED ON A FIELD SURVEY BY THIS OFFICE DATED 06/19/15 AND UPDATED WITH AS BUILT CONDITIONS ON 08/15/17.
 2. HORIZONTAL DATUM IS NAD83. VERTICAL DATUM IS NAVD88. BOTH DATUMS WERE ESTABLISHED AT THIS SITE BY GPS METHODS.
 3. BORDERING VEGETATED WETLANDS SHOWN WERE DELINEATED BY WETLAND CONSULTANTS INC., ON 06/16/15. ENTIRE LOCUS SHOWN IS WITHIN THE RIVERS PROTECTION AREA.
 4. LOCATION OF CRANBERRY BROOK IS AS MAPPED BY MAGIS/USGS HYDRO25K DATA.
 5. LOCATIONS OF UTILITIES SHOWN HEREON ARE THE RESULT OF SURFACE EVIDENCE AS LOCATED BY FIELD SURVEY AND A PLAN PROVIDED BY THE TOWN OF SPENCER. THIS PLAN DOES NOT NECESSARILY DEPICT THE EXACT LOCATIONS OF ALL UTILITIES WHICH MAY EXIST AT THIS TIME WITHIN THE PREMISES SURVEYED.
 6. THE CONTRACTOR SHOULD VERIFY THE EXISTING CONDITIONS TO HIS SATISFACTION PRIOR TO BEGINNING ANY EXCAVATION. "DIG SAFE" SHALL BE NOTIFIED AT LEAST 72 HOURS PRIOR TO BEGINNING ANY WORK.
 7. NO PROPERTY LINES ARE SHOWN ON THIS PLAN.

NO.	DATE	BY	REVISIONS

SHERMAN & FRYDRYK, LLC
Land Surveying and Engineering
3 Converse Street, Suite 203
Palmer, MA 01069

FIELD WORK: PWS/BJP
COMPS: SBW
DRAFTING: SBW
CHECKED: DJF
APPROVED: DJF

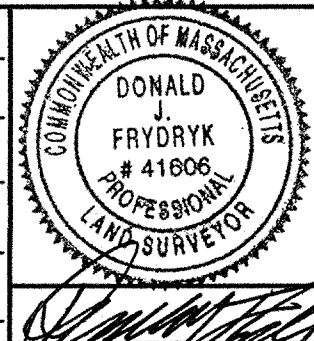

SCALE:
HORZ: 1"=20'
VERT: N/A
DATE: 09/12/2017

AS BUILT CONDITIONS

CRANBERRY BROOK WELL SITE

PLAN OF LAND IN SPENCER, MA
PREPARED FOR
TOWN OF SPENCER

PROJECT NUMBER 15057
SHEET NUMBER 1 OF 1